




SEKTION C-C



SEKTION D-D

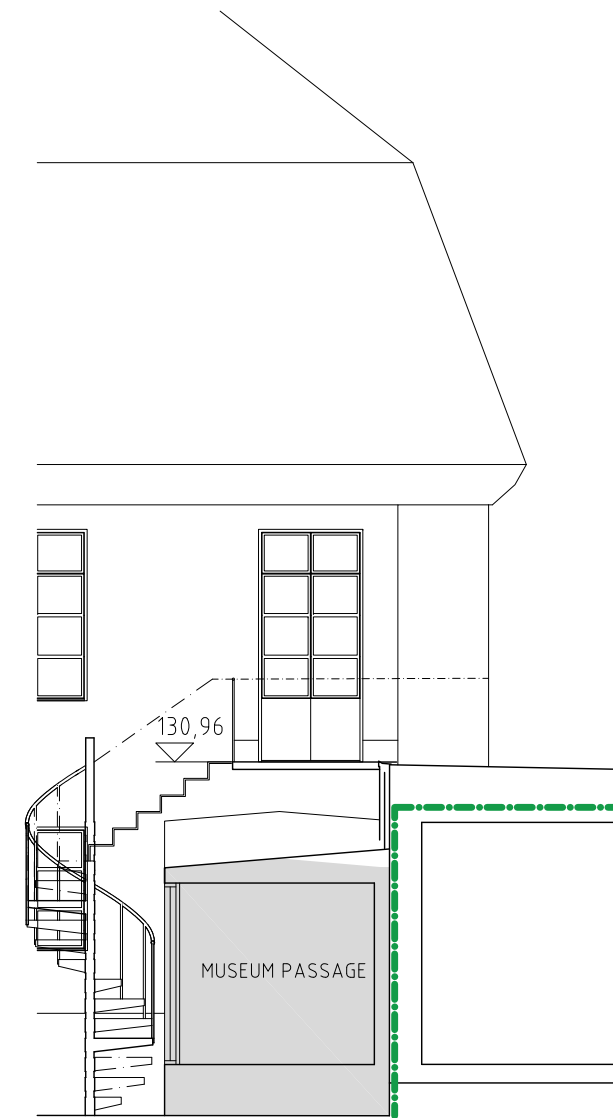

SEKTION E-E

FÖRKLARINGAR

BEFINTLIG DEL

FÖRESKRIFTER

x

HÄNVISNINGAR

- PLAN 0, DEL 1, SE RITN. A-4.0.1-001
- PLAN 0, DEL 2, SE RITN. A-4.0.1-002
- PLAN 1, DEL 1, SE RITN. A-4.0.1-003
- PLAN 1, DEL 2, SE RITN. A-4.0.1-004
- PLAN 2, DEL 1, SE RITN. A-4.0.1-005
- PLAN 2, DEL 2, SE RITN. A-4.0.1-006

X-REF:	
FILNAMN	DATUM
A_A-4.0-S-01	2017-02-14
C	
D	
E	
I	

BET	ANT	ÄNDRINGEN AVSER	DATUM	SIGN

RELATIONSHANDLING
 GESCHWORNERGÅRDEN
 FALU GRUVA

MURMAN ARKITEKTER
 PETER MYNDES BACKE 12. 118 46 STOCKHOLM
 TEL +46 (0)8 462 14 80. FAX +46 (0)8 462 14 89

UPPDRAG NR	RITAD/KONSTR AV	HANDELAGGARE
2015025	HM, RE, MHV	HM
DATUM	ANSVARIG	
2017-02-14	HM	

Sektioner
 C-C, D-D, E-E

SKALA	NUMMER	BET
1:50 (A1) 1:100 (A3)	A-4.0.2-012	A